

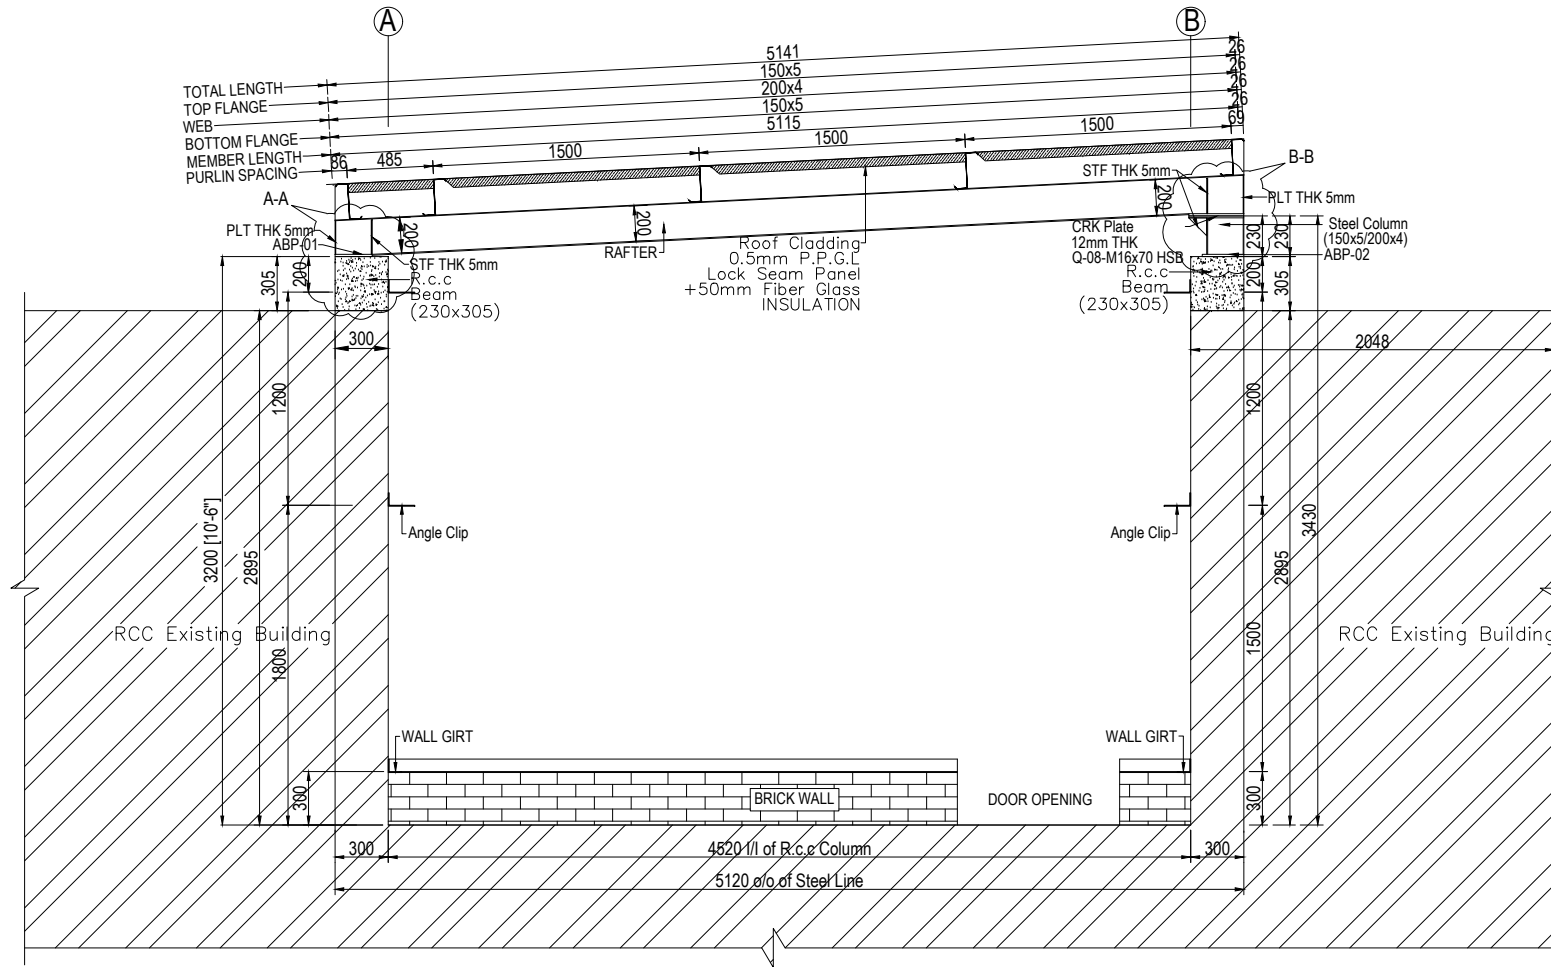


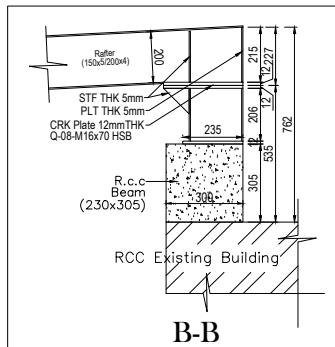

CROSS SECTION @ GRID-01

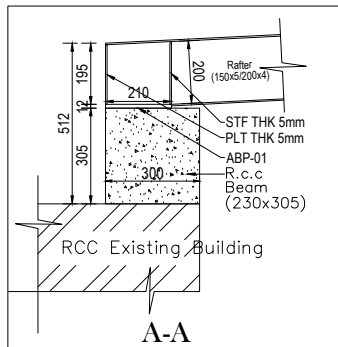

FOR APPROVAL :

IN ORDER TO SCHEDULE THIS PROJECT
IN AN EFFICIENT MANNER , KINDLY
RETURN THESE DRAWINGS WITH YOUR
ANY CHANGES MADE AFTER THE
COMMENTS MARKED IN RED

APPROVAL OF THESE DRAWINGS MAY
DELAY THE FABRICATION SCHEDULE AND
SUBSEQUENTLY THE DELIVERY OF THE
BUILDING.

PLEASE TICK MARK ONLY ONE OF THE FOLLOWING

- ☐ " APPROVED AS IS "
- ☐ " APPROVED AS NOTED "
- ☐ " RESUBMIT AS NOTED "

APPROVE : _____

SIGNATURE : _____

DATE : _____

REV.	DATE	DESCRIPTION	DRWN BY	CHK BY	APR BY
------	------	-------------	---------	--------	--------

B	24-02-22	ISSUED FOR APPROVAL	MTN	UBD	UBD
MAIMAAR MAIMAAR STEEL Pvt.Ltd 105, Raiwind Road, Thokar Niaz Baig ,Lahore, Pakistan E-mail: nasir.abbas@maimaargroup.com E-mail: maimaar.steel@gmail.com Website: www.maimaargroup.com E-mail: nasir.abbas@maimaargroup.com Mob-1 : +(92-300) 807 4017 , +(92-333) 807 1115					
JOB NO./QUOTE NO.		MSPL-034-22		BLDG #. 01	
PROJECT NAME		ROOFING STRICTURE FOR BIN RASHEED			
CUSTOMER		BIN RASHEED GROUP			
JOBSITE LOCATION		MANGA ROAD,LAHORE.			
CROSS SECTION @ GRID-01					DWG. NO. 04