

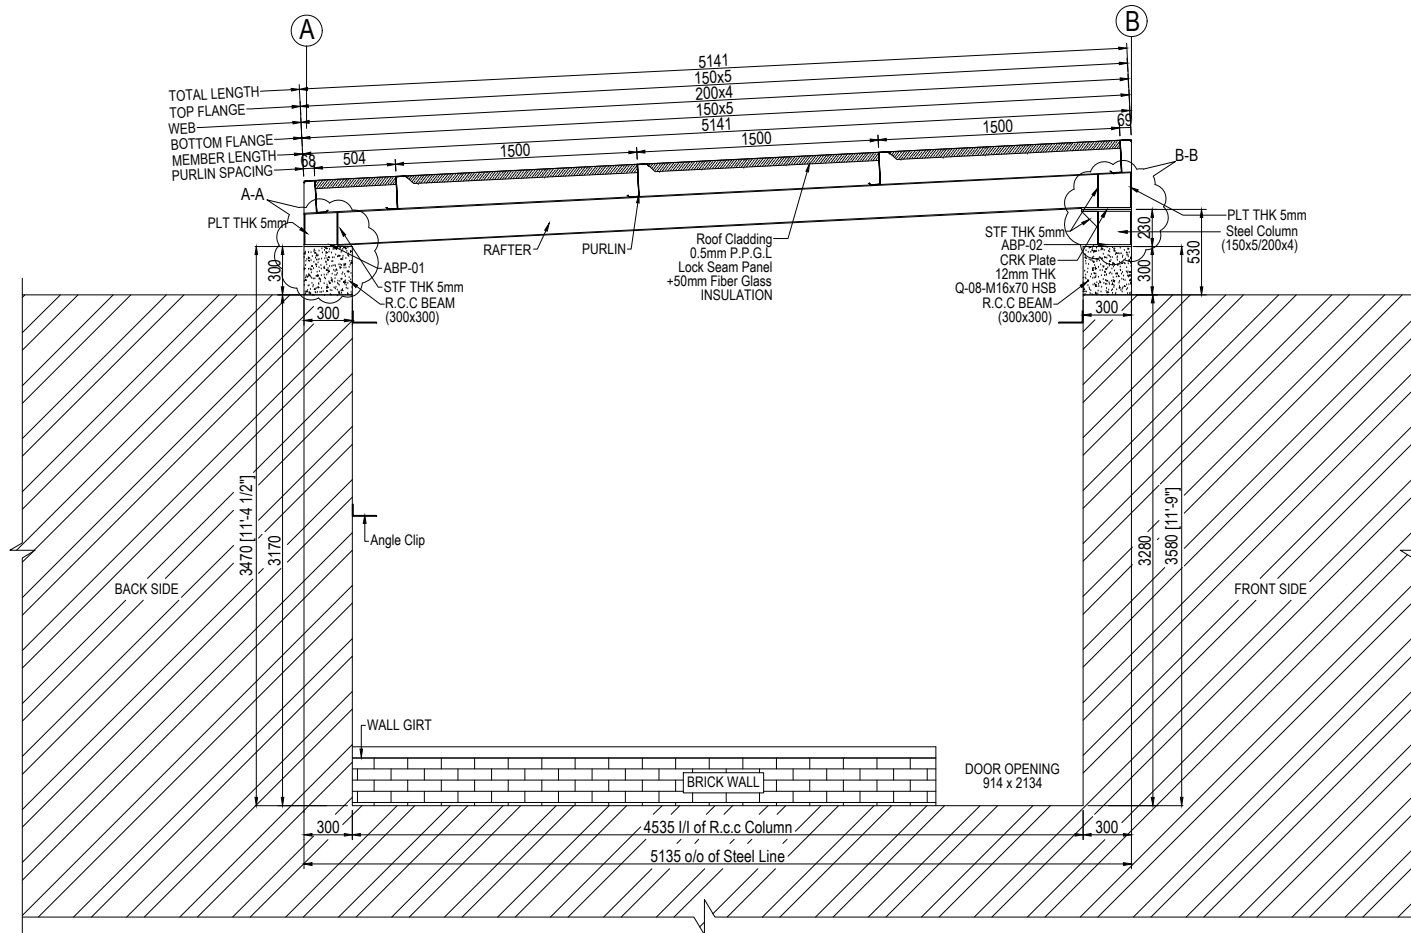


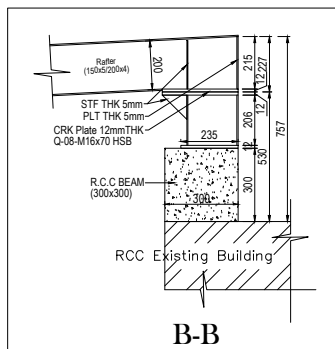

CROSS SECTION @ GRID-01

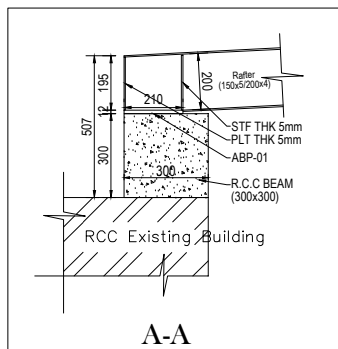

FOR APPROVAL :

IN ORDER TO SCHEDULE THIS PROJECT
IN AN EFFICIENT MANNER , KINDLY
RETURN THESE DRAWINGS WITH YOUR
ANY CHANGES MADE AFTER THE
COMMENTS MARKED IN RED

APPROVAL OF THESE DRAWINGS MAY
DELAY THE FABRICATION SCHEDULE AND
SUBSEQUENTLY THE DELIVERY OF THE
BUILDING.

PLEASE TICK MARK ONLY ONE OF THE FOLLOWING

- ☐ " APPROVED AS IS "
- ☐ " APPROVED AS NOTED "
- ☐ " RESUBMIT AS NOTED "

APPROVE : _____

SIGNATURE : _____

DATE : _____

B	11-03-22	ISSUED FOR APPROVAL	R.A	YEH	YEH
A	24-02-22	ISSUED FOR APPROVAL	MTN	UBD	UBD
REV.	DATE	DESCRIPTION	DRWN BY	CHK BY	APR BY



MAIMAAR STEEL Pvt.Ltd
105, Raiwind Road, Thokar Niaz Baig ,Lahore, Pakistan
E-mail: nasir.abbas@maimaargroup.com
E-mail: maimaar.steel@gmail.com
Website: www.maimaargroup.com
E-mail: nasir.abbas@maimaargroup.com
Mob-1 : +(92-300) 807 4017 ,+(92-333) 807 1115

JOB NO./QUOTE NO.	MSPL-034-22	BLDG #.	01
PROJECT NAME	LABORATORY BUILDING		
CUSTOMER	BIN RASHEED GROUP		
JOB SITE LOCATION	MANGA ROAD,LAHORE.		
CROSS SECTION @ GRID-02 TO 04			DWG. NO. 04