


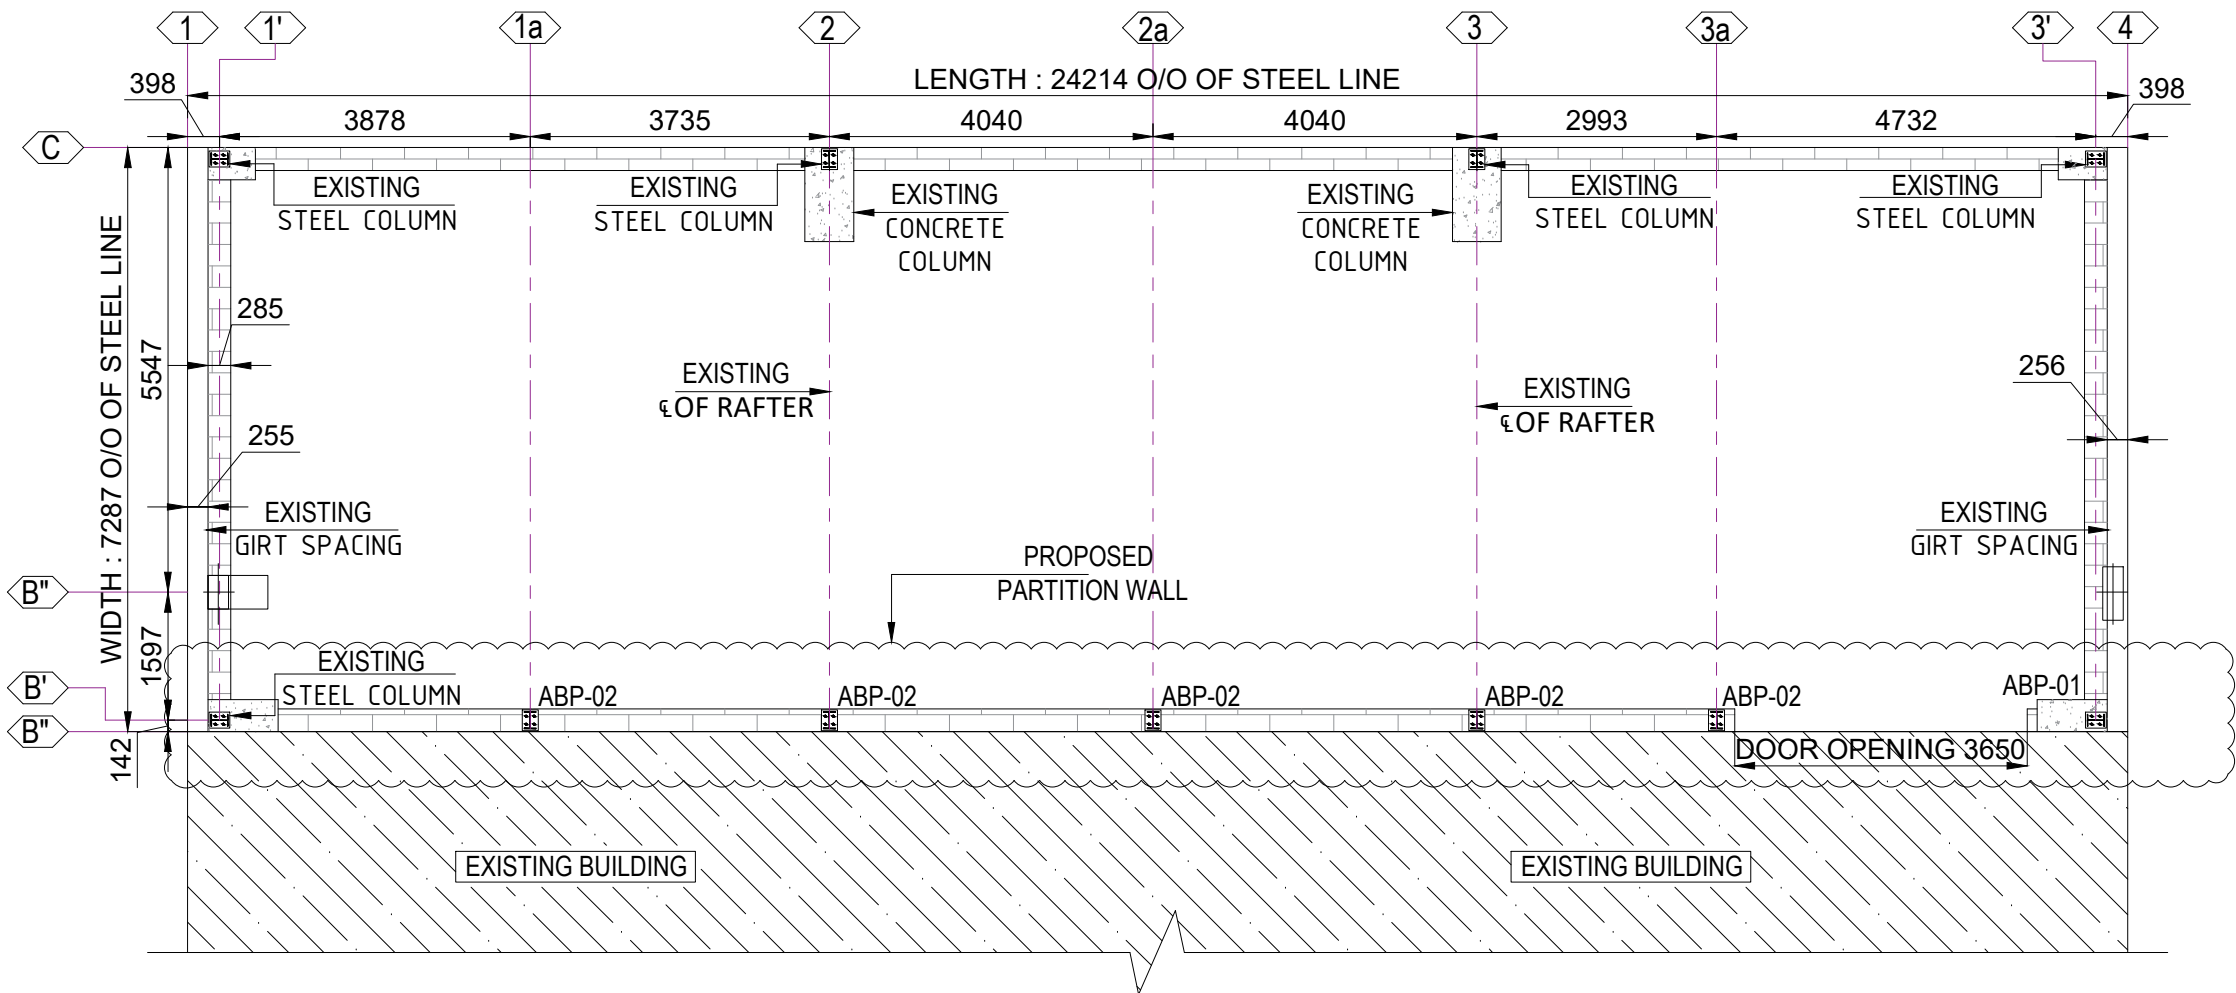

COLUMN LAYOUT PLAN

FOR APPROVAL :

IN ORDER TO SCHEDULE THIS PROJECT IN AN EFFICIENT MANNER, KINDLY RETURN THESE DRAWINGS WITH YOUR COMMENTS MARKED IN RED. APPROVAL OF THESE DRAWINGS MAY DELAY THE FABRICATION SCHEDULE AND SUBSEQUENTLY THE DELIVERY OF THE BUILDING. PLEASE TICK MARK ONLY ONE OF THE FOLLOWING

☐ " APPROVED AS IS "

☐ " APPROVED AS NOTED "

☐ " RESUBMIT AS NOTED "

APPROVE : _____

SIGNATURE: _____

DATE : _____

BUILDING DESIGN LOADS:

☐ LIVE LOAD = 2.5 KN/SQ.M

☐ DEAD LOAD = 3 KN/SQ.M

APPROVE : _____

SIGNATURE: _____

DATE : _____

00	09-12-23	ISSUED FOR APPROVAL	M.A	T.K	YEH
REV.	DATE	DESCRIPTION	DRWN BY	CHK BY	APR BY

MAIMAAR



MAIMAAR STEEL Pvt.Ltd
 238, Raiwind Road, Thokar Niaz Baig, LAHORE, Pakistan
 E-mail: nasil.Ubbas@maimaargroup.com
 E-mail: maimaar.steel@gmail.com
 Website: www.maimaargroup.com
 E-mail: nasil.Ubbas@maimaargroup.com
 Mob-1 : +(92-300) 807 4017 ,+(92-333) 807 1115

JOB NO./QUOTE NO.	MSPL-111-23	BUILDING #	01
PROJECT NAME	PARTITION WALL		
CUSTOMER	STYLE TEXTILE		
JOBSITE LOCATION	LAHORE		

COLUMN LAYOUT PLAN

DWG. NO.
01